
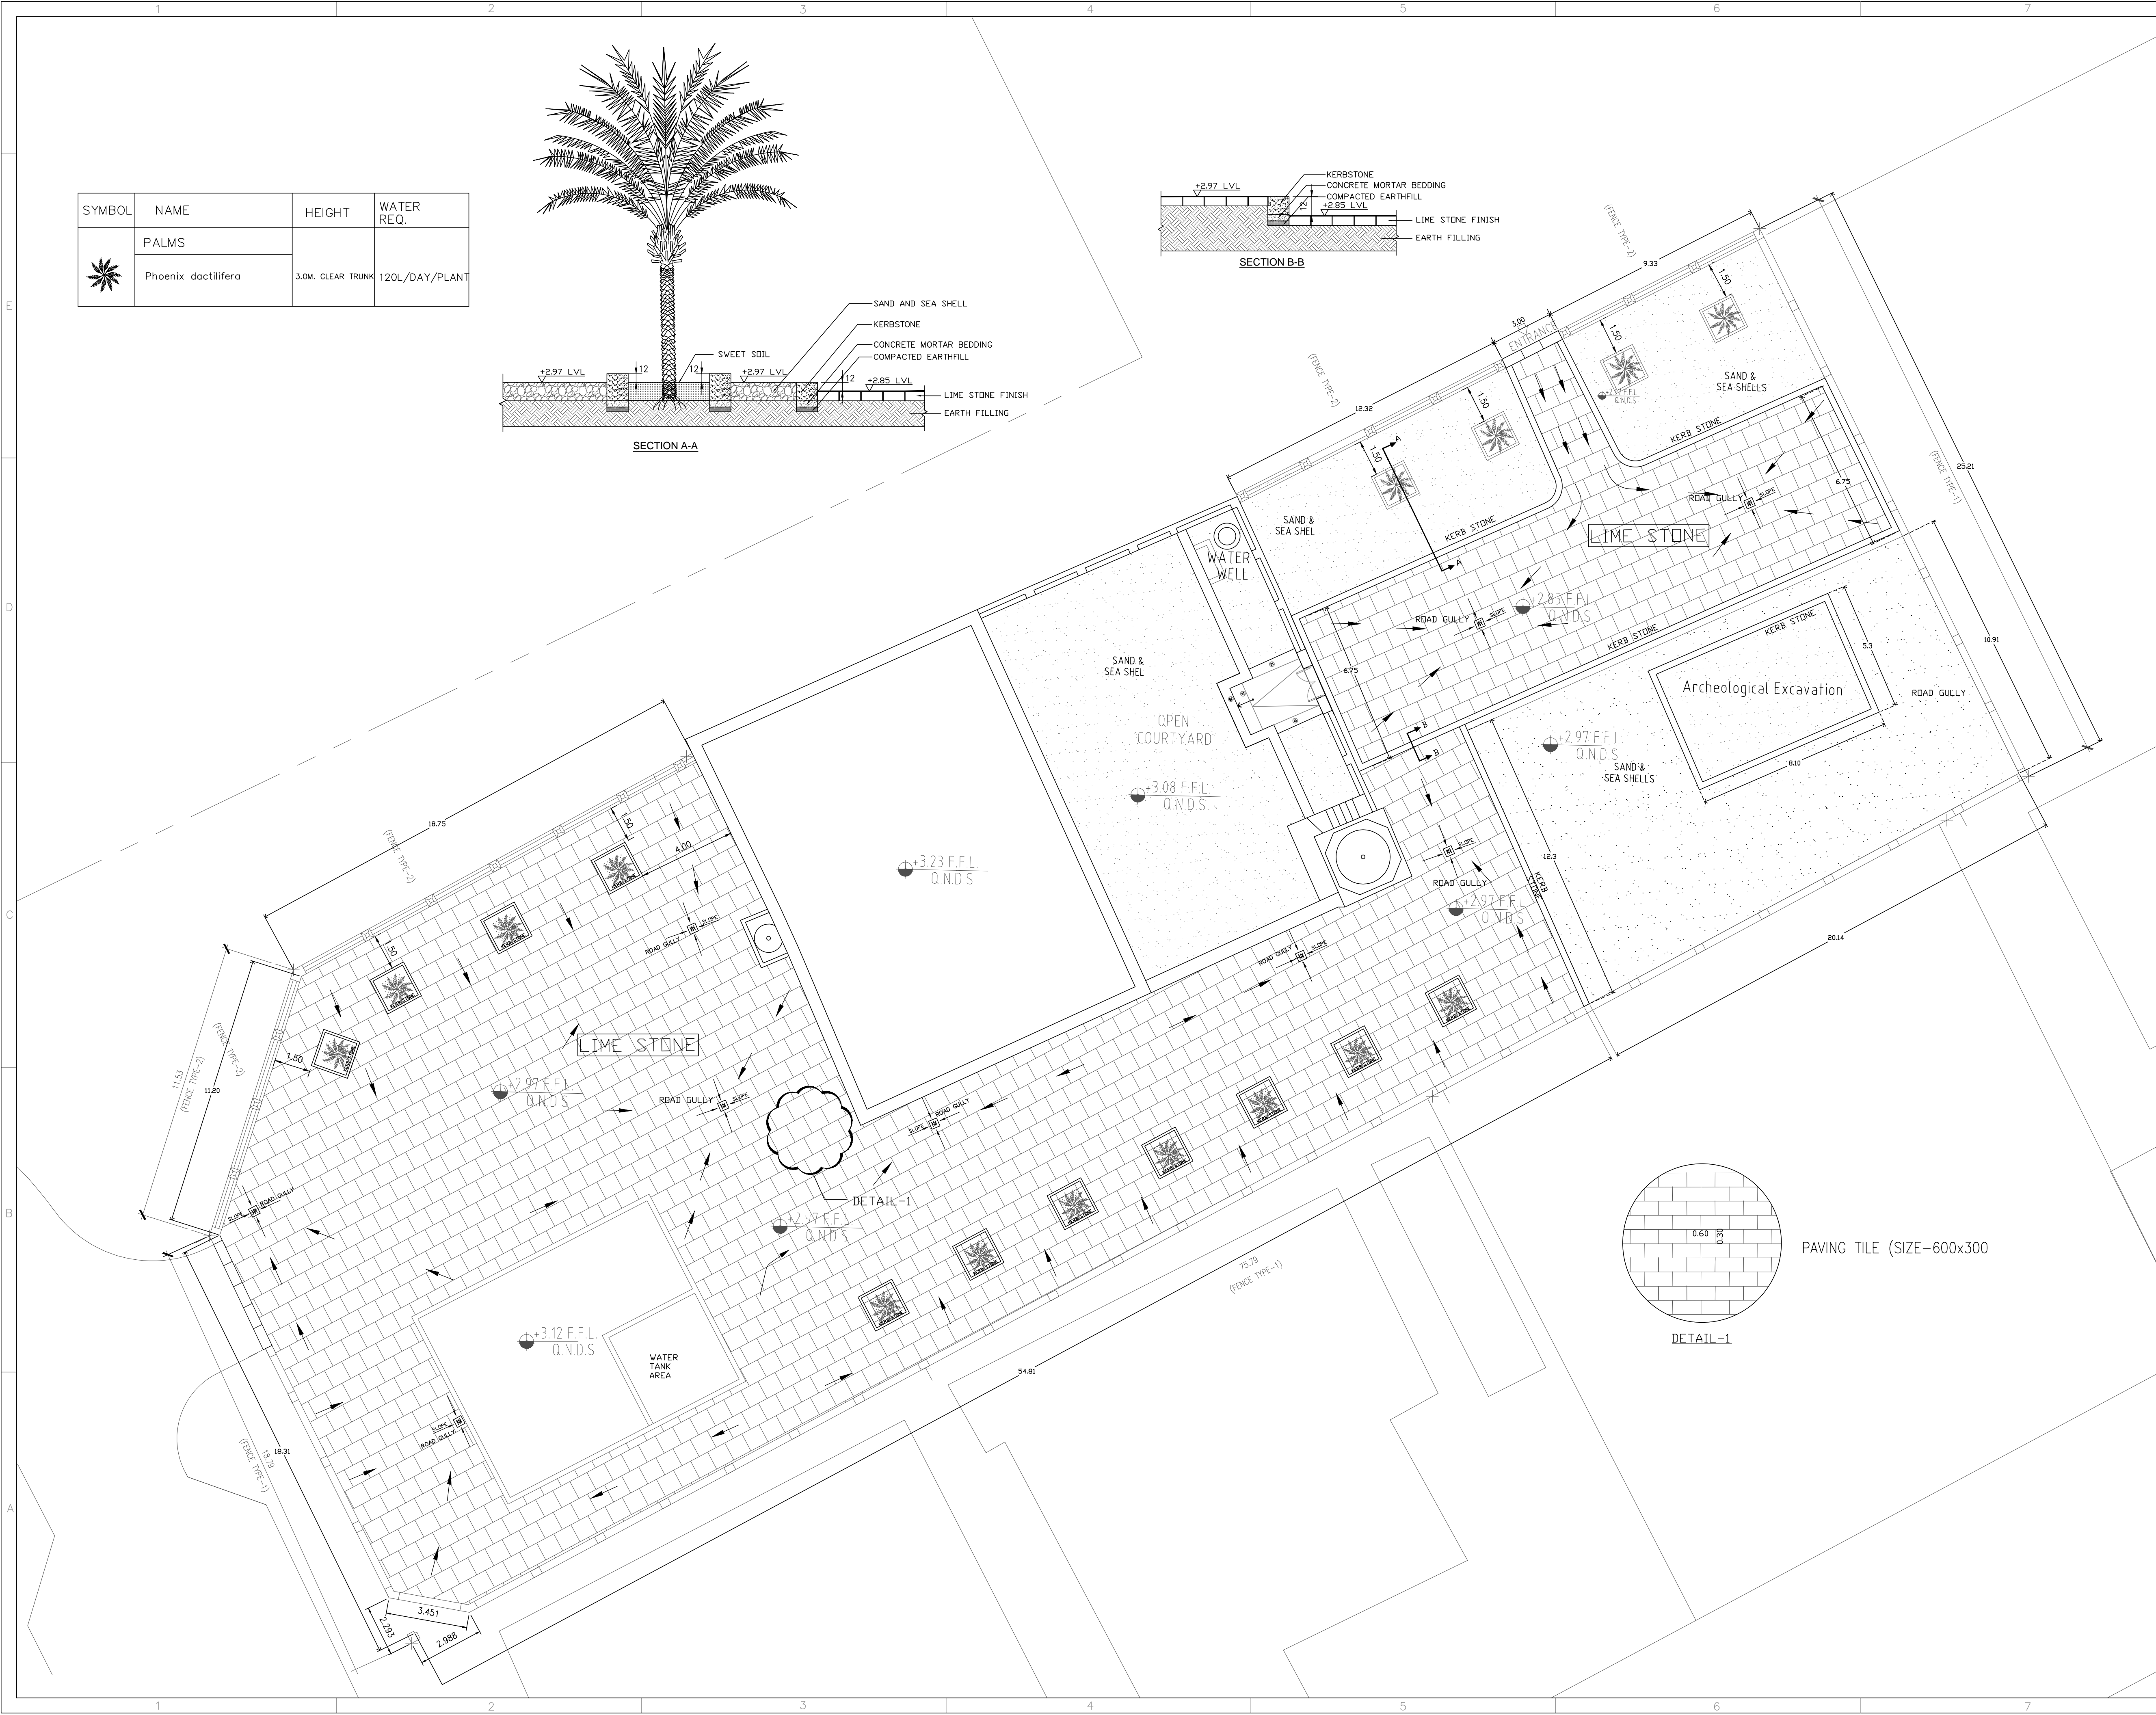
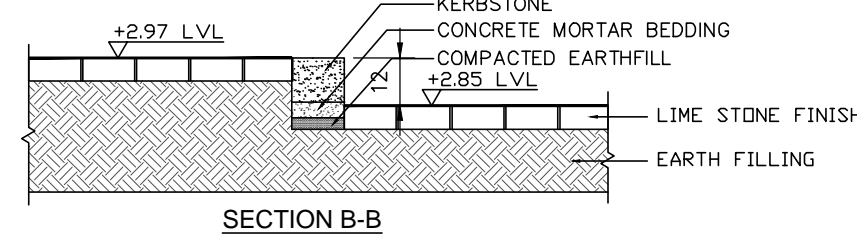
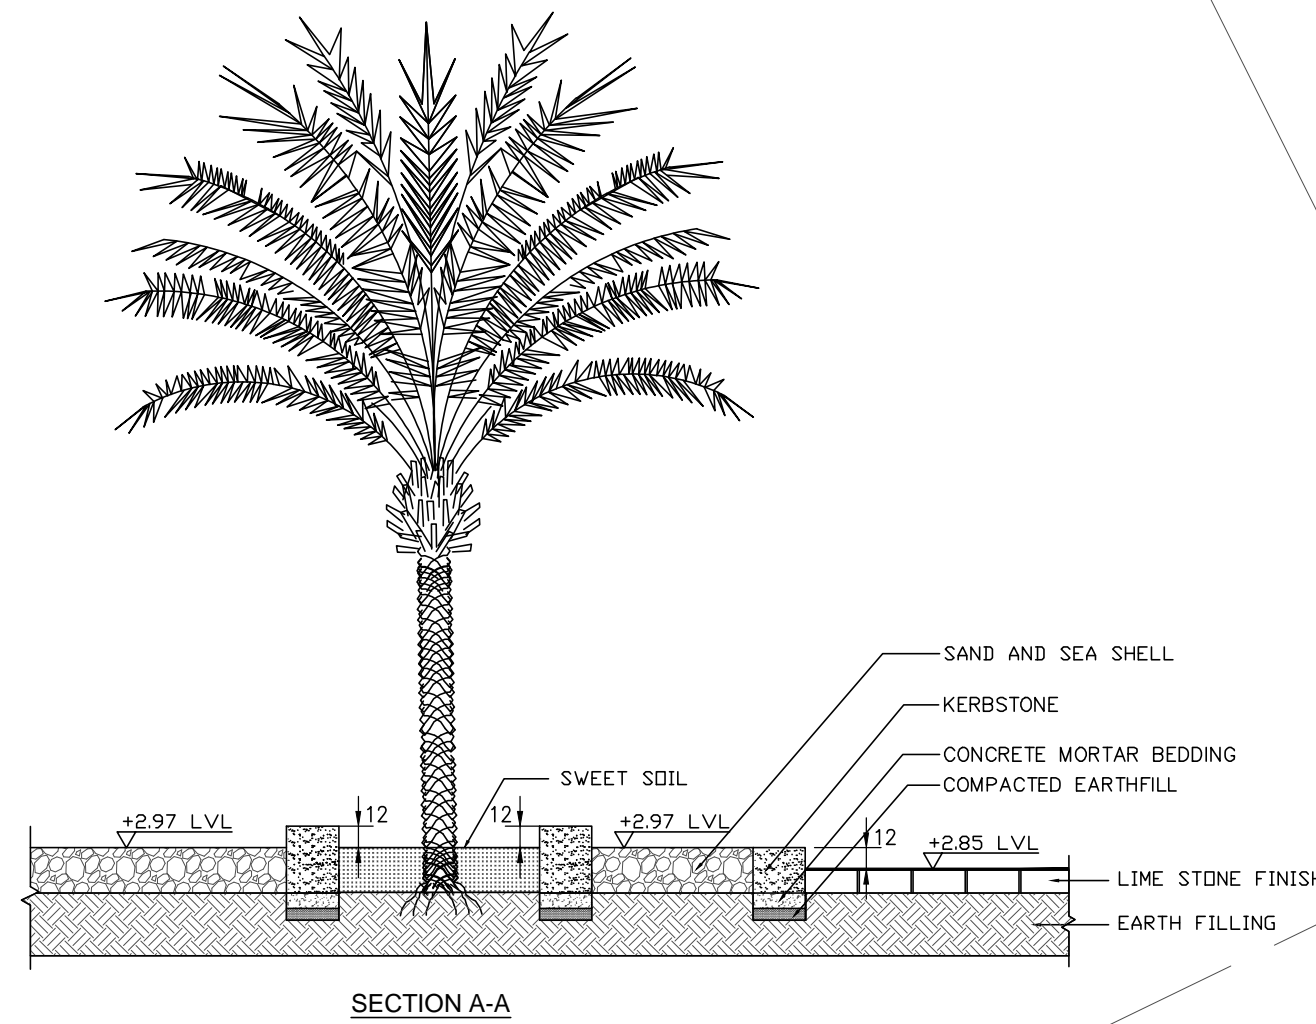


SYMBOL	NAME	HEIGHT	WATER REQ.
	PALMS		
	Phoenix dactylifera	3.0M. CLEAR TRUNK	120L/DAY/PLANT



- NOTES:**
1. ALL DIMENSIONS GIVEN ON THIS DRAWING ARE IN MILLIMETERS. DO NOT SCALE THE DRAWINGS. ANY DISCREPANCIES FOUND SHOULD BE REPORTED TO THE RESPONSIBLE ARCHITECT OR ENGINEER IMMEDIATELY.
  2. IT IS THE RESPONSIBILITY OF THE CONTRACTOR OR BUILDERS TO ASCERTAIN AND CONFIRM THAT ALL DIMENSIONS SHOWN IN THESE DRAWINGS SHALL COMPLY WITH THE SITE DIMENSIONS AND LEVELS PRIOR TO PREPARING DRAWINGS AND EXECUTING THE WORKS.
  3. ALL WORKS ARE TO BE CARRIED OUT TO Q.C.S. AND OTHER RELEVANT CODES OF CONSTRUCTIONS.
  4. ALL COORDINATES & LEVEL SHOWN IN THE DRAWINGS ARE BASE FROM SITE SURVEY LEVEL.

**AS BUILT DRAWING**

COORDINATION AND NO OBJECTION TABLE			
NAME	STRU.	ARCH.	MECH. / ELEC.
SIGN.			

REFERENCE DESIGN DRAWINGS		
NO.	DRAWING NO	TITLE
1	A-PR-02	PROPOSED GROUND FLOOR PLAN
2		


COMPLEMENTARY RELATED DRAWINGS		
NO.	DRAWING NO	TITLE
1		
2		

APPROVED	REVIEWER SIGNATURE
<input type="checkbox"/>	NOTES
<input type="checkbox"/>	Signature
<input type="checkbox"/>	
<input type="checkbox"/>	

REV.	DESCRIPTION	DATE	DWN	CHKD	APPD
0	AS BUILT	05.09.2016	LG	BA	GW


PROJECT NO.: QMA-2014-30

PROJECT: REHABILITATION OF AL RUWAIS MOSQUE

CLIENT:  QATAR MUSEUM'S AUTHORITY

CONSULTANT:  **EGEC QATAR**  
ENGINEERING CONSULTANTS  
P.O. BOX 7188, Doha, Qatar  
Tel: +974 4442 8874 / 421 2047  
Fax: +974 4442 9027  
www.egec-qatar.com  
egec.qatar@egec-qatar.com

DESIGN CONSULTANT:  **المعهد العربي للهندسة المعمارية**  
Arab Engineering Bureau  
AEB HEADQUARTERS: P.O. BOX 14678, Doha, Qatar  
Tel: +974 4442 8874 / 421 2047  
Fax: +974 4442 9027  
www.aeb-qatar.com  
OTHER BRANCHES: ABU DHABI - MANAMA - MUSCAT

MAIN CONTRACTOR:  **AL FOWRIYA TRADING & CONTRACTING W.L.L.**  
P.O. BOX: 34110  
DOHA - QATAR  
TEL: +974 4442 8874 / 421 2047  
FAX: +974 4442 9027  
E-MAIL: alfowriya@gmail.com

DRAWING TITLE: LANDSCAPING & WALKPAVEMENT LAYOUT

DRAWING NO.:	REVISION NUMBER
A-10	00

DRAWN BY	REVIEWED BY	APPROVED BY	DATE	SHEET NO.
LAIBIN	BASIL	GOOWIN	05-09-2016	1 of 1
SCALE	SIZE	COMPUTER REFERENCE		
AS SHOWN	A1			